

JUN 13 P2:04

PB 7-84

# MAINTENANCE MAP FOR A PORTION OF

# MacARTHUR BOULEVARD

LOCATED IN SECTIONS 5 AND 8, TOWNSHIP 38 S., RANGE 42 E.  
AND SECTIONS 31 AND 32, TOWNSHIP 37 S., RANGE 42 E.  
MARTIN COUNTY, FLORIDA  
APRIL, 1979

### ACCEPTANCE

ACCEPTED FOR FILES AND RECORDED IN THE PUBLIC RECORDS OF MARTIN COUNTY, FLORIDA. THIS 13<sup>th</sup> DAY OF JUNE A.D., 1979 IN PLAT BOOK 7 PAGE 84. File # 344164

Louise V. Isaacs  
CLERK OF CIRCUIT COURT OF MARTIN COUNTY, FLORIDA  
By Charlotte Burkley, OC

### SURVEYOR'S CERTIFICATION

I HEREBY CERTIFY THAT THE SURVEY INFORMATION SHOWN HEREON IS A CORRECT REPRESENTATION OF A SURVEY MADE UNDER MY DIRECTION AND THAT IT IS CORRECT TO THE BEST OF MY KNOWLEDGE AND BELIEF.

G. M. Korman  
GARY M. KORMAN  
REGISTERED LAND SURVEYOR  
FLORIDA CERTIFICATE NO. 2633

### ACKNOWLEDGEMENT

SWORN TO AND SUBSCRIBED BEFORE ME THIS 6<sup>th</sup> DAY OF JUNE, 1979 BY C. E. RAULERSON AS SUPERINTENDENT, AT STUART, MARTIN COUNTY, FLORIDA.  
WITNESS MY HAND AND OFFICIAL SEAL IN THE COUNTY AND STATE LAST AFORESAID THIS 6<sup>th</sup> DAY OF JUNE, 1979.

Caroline J. Burt  
NOTARY PUBLIC, STATE OF FLORIDA AT LARGE  
MY COMMISSION EXPIRES: Aug. 5, 1980


### DEDICATION

PURSUANT TO SECTION 95.361(1), FLORIDA STATUTES, (1977) THE PORTIONS OF MAC ARTHUR BOULEVARD BETWEEN STATION 0+00.00 AND STATION 98+30.97 AND BETWEEN THE MAINTENANCE RIGHT-OF-WAY LINES, ALL WITHIN MARTIN COUNTY AND LOCATED AS SHOWN ON THE ABOVE MAP, SHALL HEREAFTER BE DEEMED DEDICATED TO THE PUBLIC AND ALL RIGHT, TITLE, EASEMENTS AND APPURTENANCES ARE HEREBY VESTED IN MARTIN COUNTY, FLORIDA.

CERTIFIED BY: BOARD OF COUNTY COMMISSIONERS  
Louise V. Isaacs BY: Frank A. Wacha  
LOUISE V. ISAACS, CLERK FRANK A. WACHA, CHAIRMAN  
By Charlotte Burkley, OC

### INDEX

1 OF 4 COVER SHEET  
2-4 OF 4 RIGHT-OF-WAY MAINTENANCE MAP

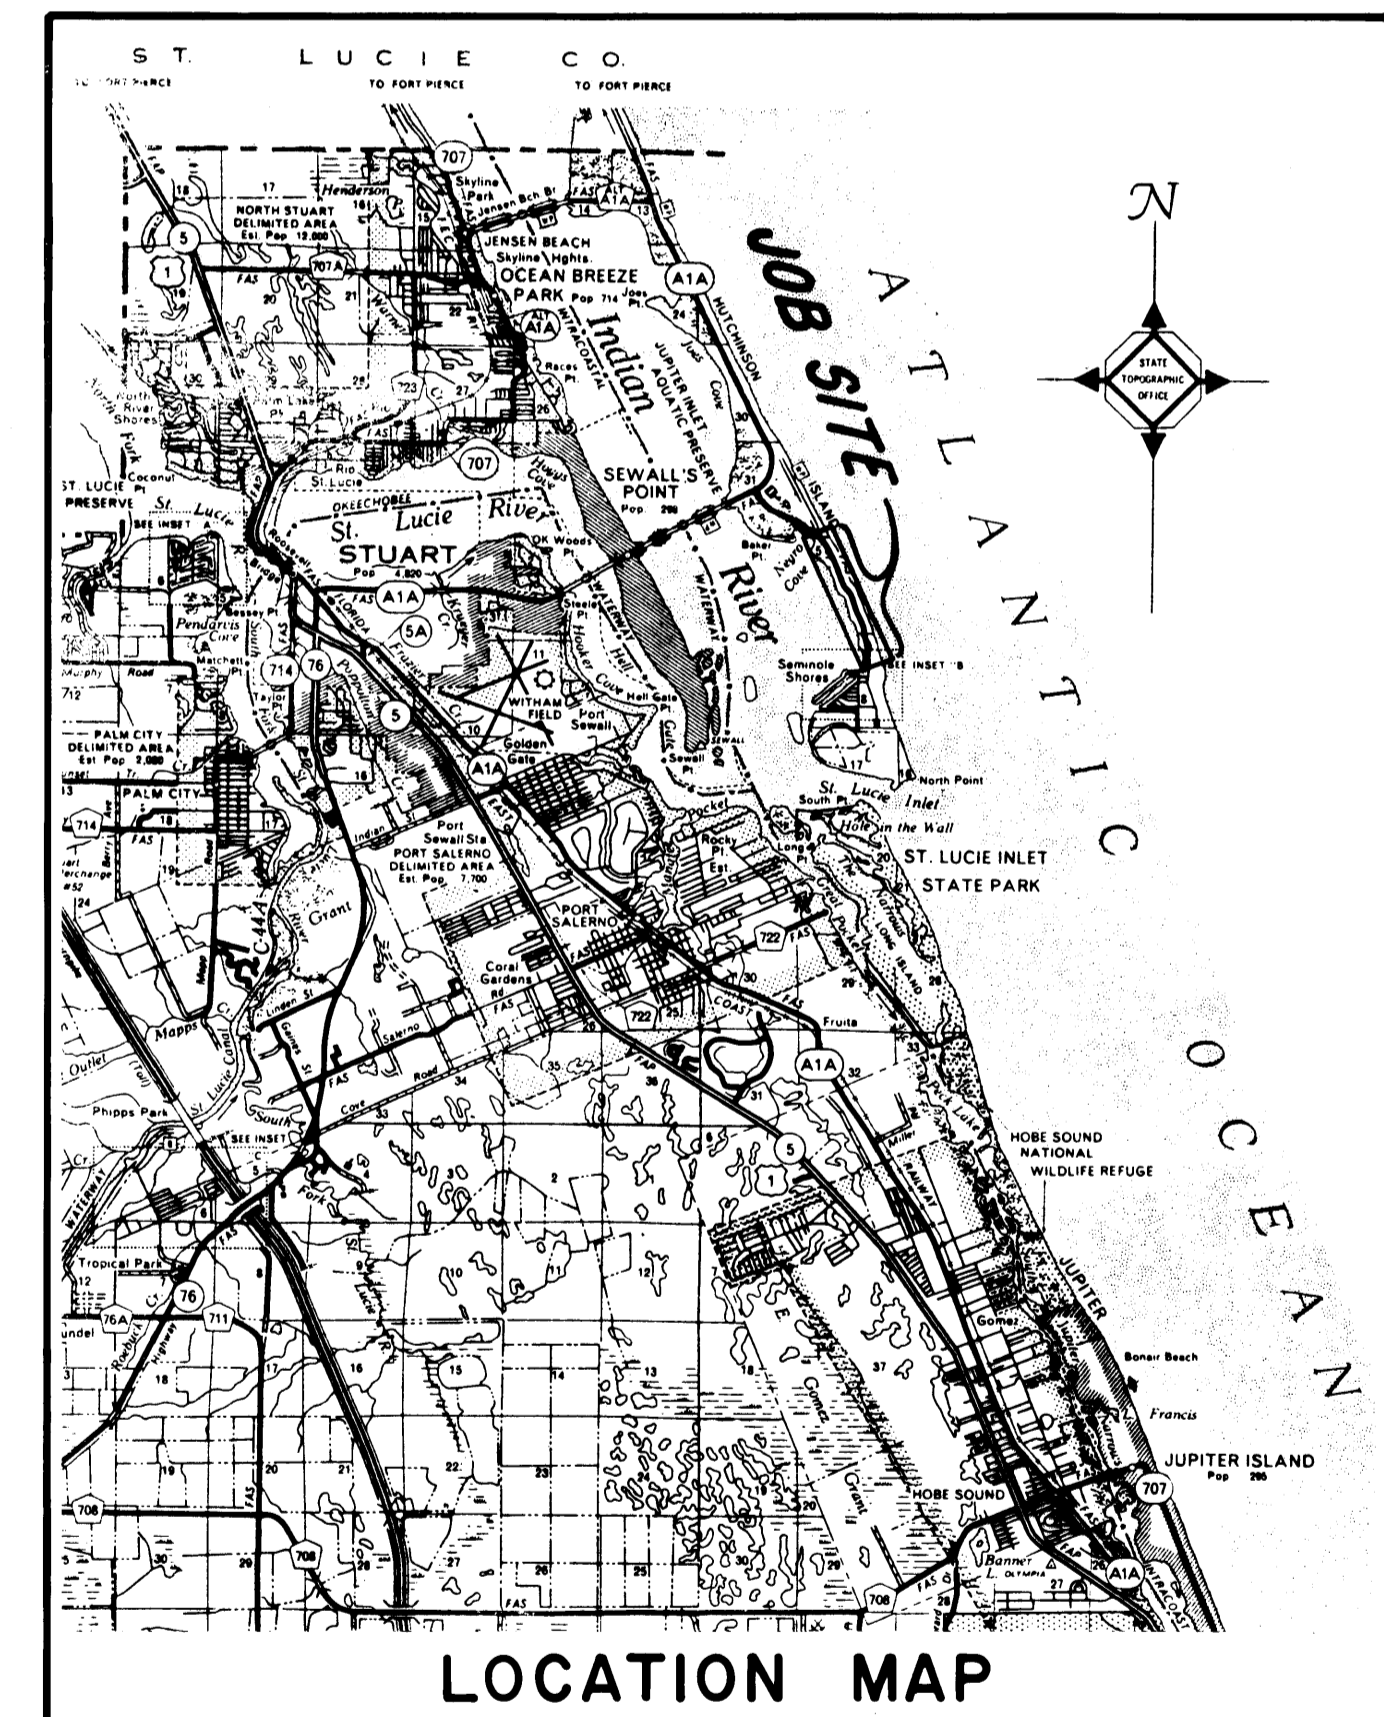

### AFFIDAVIT

STATE OF FLORIDA  
COUNTY OF MARTIN  
BEFORE ME, THE UNDERSIGNED AUTHORITY, DULY AUTHORIZED IN THE STATE AND COUNTY AFORESAID TO ADMINISTER OATHS AND TAKE ACKNOWLEDGEMENTS, PERSONALLY APPEARED C. E. RAULERSON, AS ROAD SUPERINTENDENT, WHO AFTER BEING DULY SWORN, DEPOSES AND SAYS ON OATH AS FOLLOWS:  
1. I, THE UNDERSIGNED, BEING COUNTY ROAD SUPERINTENDENT OF MARTIN COUNTY, FLORIDA, AND AS SUCH A DULY QUALIFIED EMPLOYEE OF SAID MARTIN COUNTY, DO AVER THAT I AM THOROUGHLY FAMILIAR WITH ALL OF THE ROADS OF MARTIN COUNTY, FLORIDA; AND WITH THE PROGRAM OF MAINTENANCE AND IMPROVEMENT THEREOF. THAT I HAVE BEEN ASSOCIATED IN PRESENT OF SIMILAR CAPACITY ON ROAD PROGRAMS IN SAID COUNTY FOR A PERIOD IN EXCESS OF 19 YEARS.  
2. THAT TO MY PERSONAL KNOWLEDGE AND OBSERVATION THE ROAD KNOWN AND DESCRIBED AS A PORTION OF MAC ARTHUR BOULEVARD, LYING SOUTH OF STATE ROAD A-1-A ALL WITHIN MARTIN COUNTY AS LOCATED AS SHOWN ON THE ABOVE MAP WAS CONSTRUCTED BY AND HAS BEEN MAINTAINED AND REPAIRED CONTINUOUSLY AND UNINTERRUPTED FOR 19 YEARS BY THE MARTIN COUNTY ROAD AND BRIDGE DEPARTMENT. FURTHER THAT THE MAINTENANCE OF SAID PORTION OF MAC ARTHUR BOULEVARD CONSISTS OF MOWING, PERIODIC MAINTENANCE OF SWALE, GRADING OF SHOULDER, AND PATCHING OF EXISTING PAVEMENT.  
FURTHER AFFIANT SAYETH NOT.  
THIS 6 DAY OF JUNE, 1979.

C. E. Raulerson  
ROAD SUPERINTENDENT

			FIELD		LINDAHL, BROWNING & FERRARI, INC. CONSULTING ENGINEERS, PLANNERS & SURVEYORS		
			DRAWN BY	LEONIET	426 INDIANTOWN ROAD P.O. BOX 727 JUPITER FLORIDA 33458		
			CHECKED BY		951 COLORADO AVENUE SUITE 110 STUART FLORIDA 34994		
DATE	BY	DESCRIPTION	DATE	APRIL 1979	SCALE:	DR. NO.	SHEET 1 OF 4
REVISION			JOB NO.	78-594			