

CERTIFICATE

THIS IS TO CERTIFY THAT THE WITHIN AND ATTACHED SHEETS NUMBERED 1 TO 2, INCLUSIVE, CONSTITUTE A TRUE COPY OF THE OFFICIAL RIGHT OF WAY MAP SHOWING LOCATION AND SURVEY BY THE STATE OF FLORIDA DEPARTMENT OF TRANSPORTATION FOR A PORTION OF STATE ROAD 707, DESIGNATED AS SECTION 89030 IN MARTIN COUNTY, FLORIDA.

THE PROPERTY OUTLINED IN RED INK, AND LABELED MAINT. R/W LINE ON THE SAID SHEETS HAS BEEN VESTED IN THE STATE OF FLORIDA DEPARTMENT OF TRANSPORTATION, PURSUANT TO THE PROVISIONS OF SECTION 95.361 FLORIDA STATUTES.

IN WITNESS WHEREOF, WE HAVE HEREUNTO SET OUR HANDS AND AFFIXED THE SEAL OF THE STATE OF FLORIDA DEPARTMENT OF TRANSPORTATION, AT TALLAHASSEE, FLORIDA, THIS 12th DAY OF AUGUST A.D. 1980.

/S/ WILLIAM N. ROSE
 SECRETARY OF TRANSPORTATION,
 STATE OF FLORIDA DEPARTMENT
 OF TRANSPORTATION

/S/ TINA T. PEPPER
 ACTING: EXECUTIVE SECRETARY,
 STATE OF FLORIDA DEPARTMENT
 OF TRANSPORTATION


THIS IS TO CERTIFY THE RIGHT OF WAY LIMITS AS SHOWN ON THIS MAP HAVE BEEN MAINTAINED CONTINUOUSLY FOR FOUR (4) YEARS WITHOUT INTERRUPTION OR DISTURBANCE BETWEEN MILE POSTS 26.150 AND 26.260 (S.L.D.)

/S/ J.R. THAXTON
 MAINTENANCE ENGINEER

ACCEPTED FOR FILES AND RECORDED IN THE PUBLIC RECORDS OF MARTIN COUNTY, FLORIDA, THIS 20th DAY OF AUGUST A.D. 1980 IN RIGHT OF WAY ROAD PLAT BOOK 8 PAGE 33.

/S/ LOUISE V. ISAACS
 CLERK OF CIRCUIT COURT OF
MARTIN COUNTY, FLORIDA

STATE OF FLORIDA DEPARTMENT OF TRANSPORTATION				
MAINTENANCE MAP				
STATE ROAD No. <u>707</u>		COUNTY <u>MARTIN</u>		
BY	DATE	APPROVED	DATE	
DRAWN	STOUT	7-15-80	<i>William E. Gray</i> 7-15-80	
TRACED			DISTRICT ENGINEER	
CHECKED	GRAY	7-15-80	ENGINEER OF RIGHT OF WAY	
COMPARED			STATE HIGHWAY ENGINEER	
INDEXED				
REVISION	BY	DATE	SECTION <u>89030</u> SHEET <u>1</u> OF <u>2</u>	

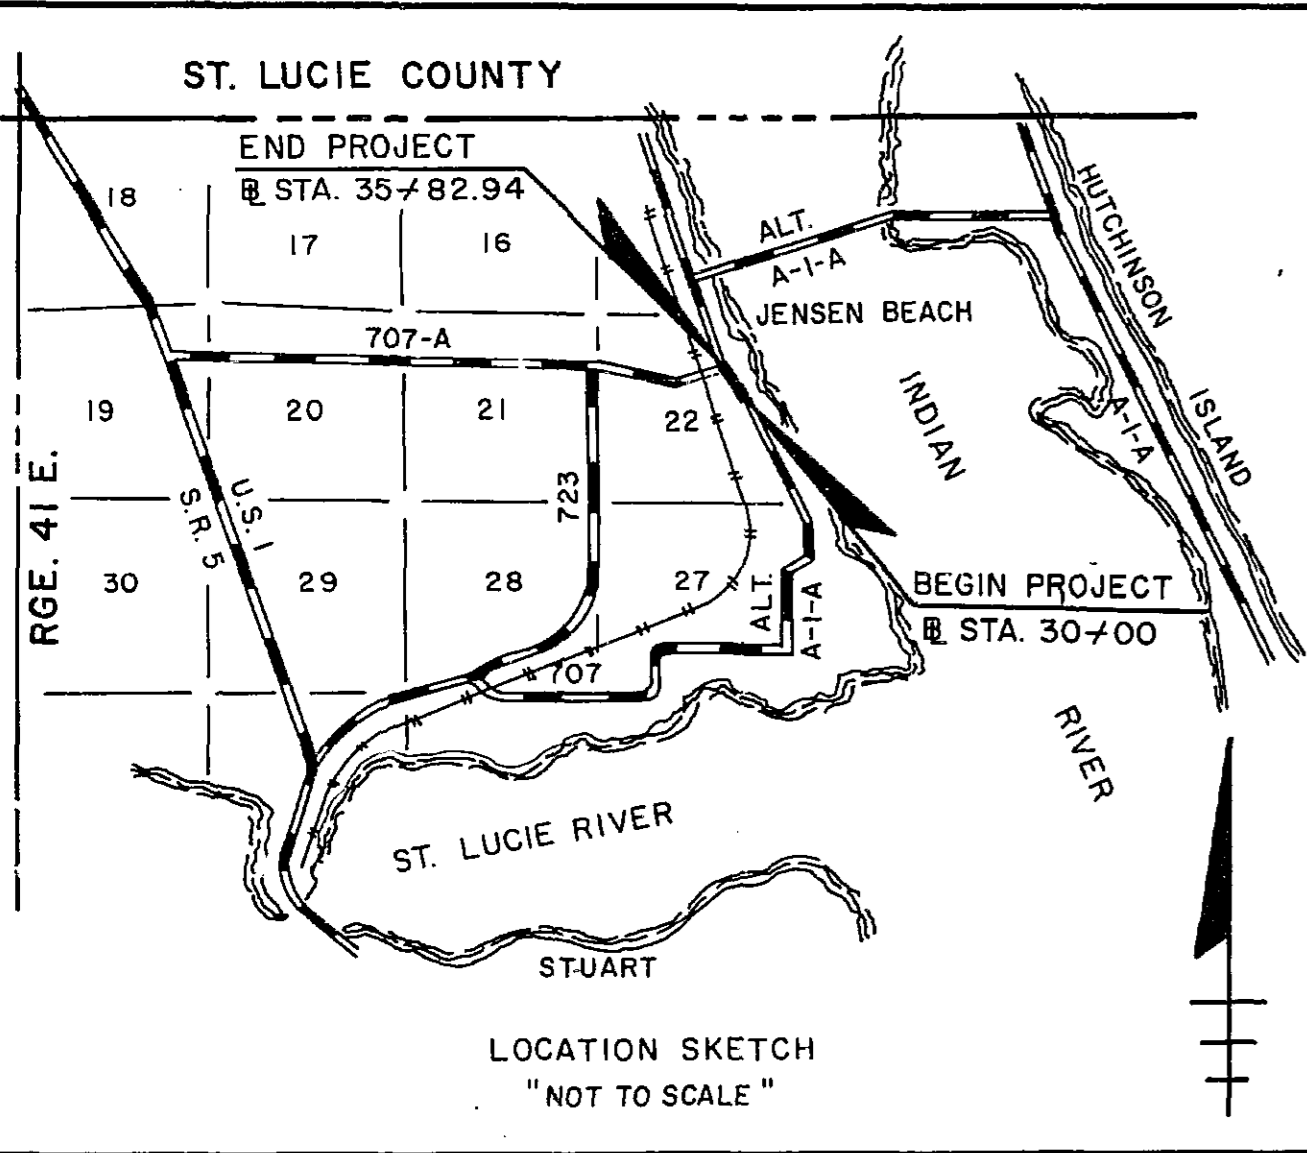

SCALE 1" = 30'
SEC. 22
TWP. 37 S., RGE. 41 E.

BEGIN PROJECT
@ STA. 30+00

END PROJECT
@ STA. 35+82.94 S.R. 707 =
@ STA. 164+60.00 S.R. 707-A
89530-2152

MAINT. R/W TABULATION

STA.	LEFT	RIGHT
30+00	17'	17'
31+00	19'	17'
31+50	19'	18'
32+00	19'	18'
32+88		18' BK.
		13.4' AHD.
33+00	19'	13.4' BK. CURB
34+00	24'	6.5' BK. CURB
34+50	27'	5.0' BK. CURB
35+00	27'	5.4' BK. CURB
35+50	27'	8'
35+82.94	27'	14'

REFERENCES:

BEARING—89530-2152 S.R. 707-A
SURVEY BOOK NO. 1023563

P.I. STA. 32+97.97
Δ = 8°08'51" RT.

STATE OF FLORIDA
DEPARTMENT OF TRANSPORTATION

MAINTENANCE MAP

STATE ROAD NO. 707 MARTIN COUNTY

BY	DATE	APPROVED
STOUT	5-7-80	<i>William E. Stout</i>
TRACED	STOUT	7-15-80
CHECKED	GRAY	7-15-80
COMPARED		
INDEXED		

ENGINEER OF RIGHT OF WAY
STATE HIGHWAY ENGINEER

SECTION 89030 SHEET 2 OF 2

